


Southeast Telephone Co.
Wind Lake Exchange
Counties - Racine, ~~Walworth~~, Waukesha

P.S.C. of W. No. 1
Sheet No.
Amendment No. 31

EXCHANGE AREA BOUNDARY

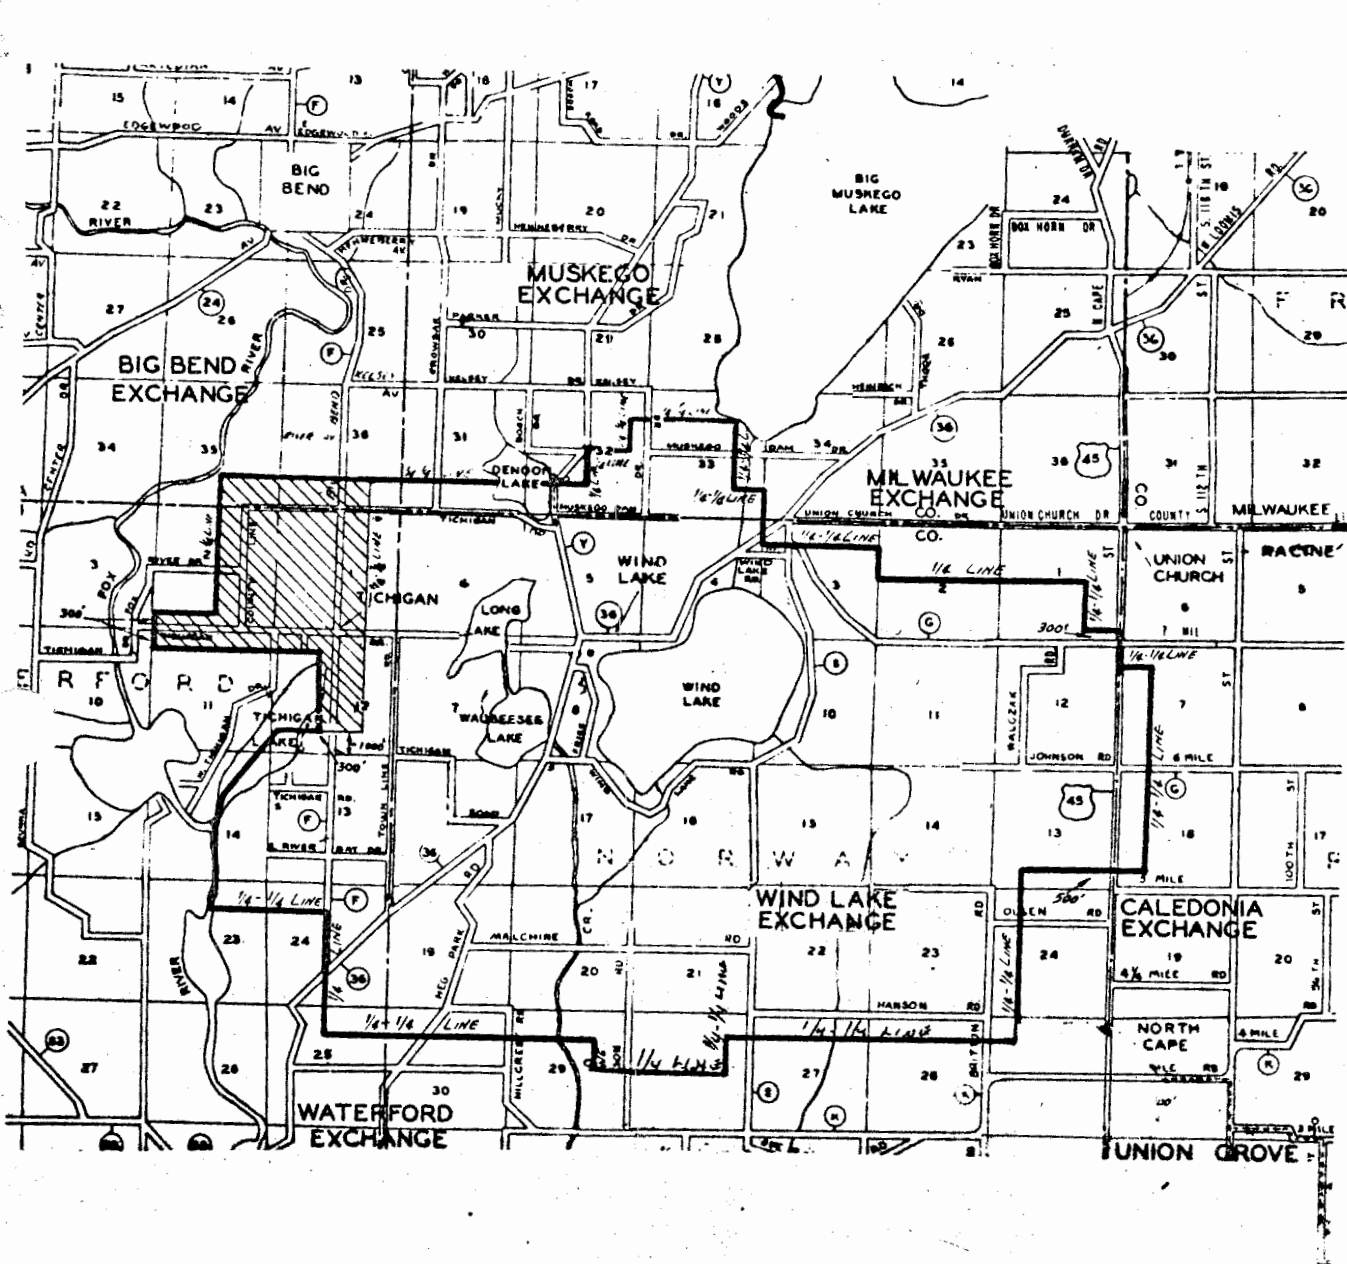

- Central Office
 - Exchange Area Boundary Line
 - ▨ Open Territory
 - ← Present Customer in Foreign Territory
 - Town Line
- Distance of Boundary Line Less than 1/4 Mile
from Highway or Section Line indicated in Feet


PSCW acceptance by
Letter dated 2-21-69

Effective: 2-21-69

Southeast Telephone Co.
Wind Lake Exchange
Counties - Racine, Walworth, Waukesha

P.S.C. of W. No. 1
Sheet No
Amendment No. 17

LOCAL BASE RATE AREA
~~EXCHANGE BASE RATE AREA~~ BOUNDARY

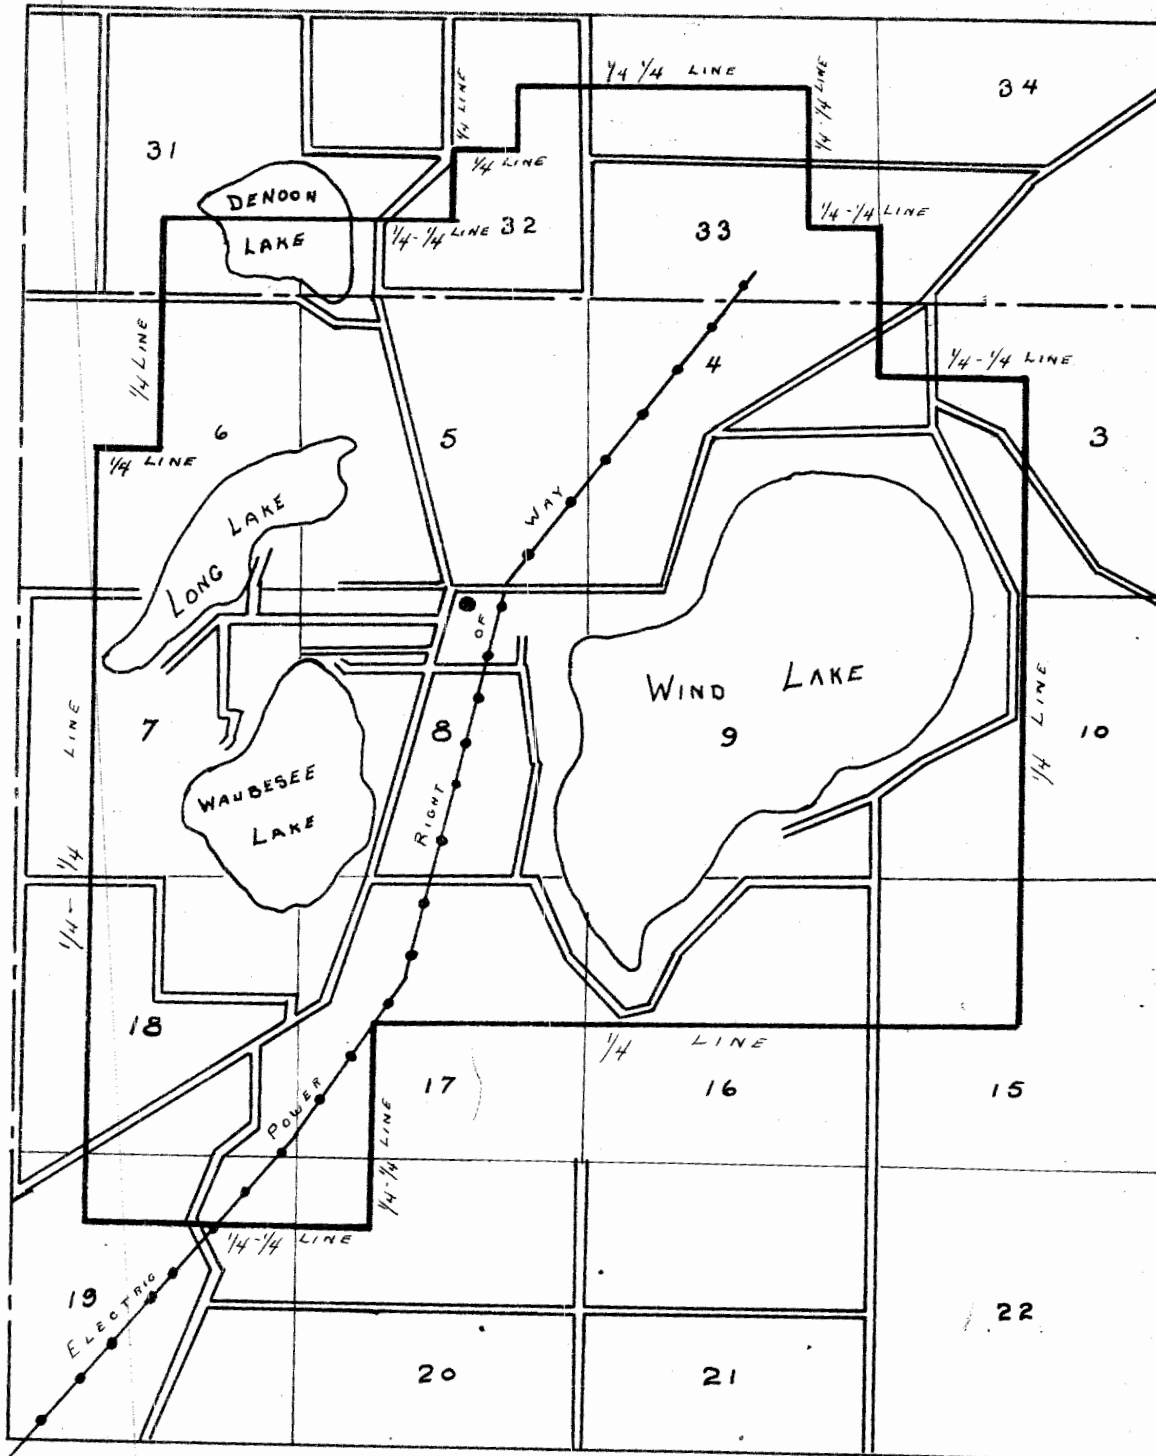

Code

• Central Office

— Exchange Base Area Boundary Line

--- Town Line

Distance of Boundary Line Less than 1/4 Mile
from Highway or Section Line indicated in Feet

PSCW acceptance by
Letter dated

12/9/58

Effective: 7-1-59